
THIS DRAWING IS UNPUBLISHED. RELEASED FOR PUBLICATION 1997
© COPYRIGHT 1997 BY TYCO ELECTRONICS CORPORATION. ALL RIGHTS RESERVED.

LOC	DIST
A1	–


REVISIONS

P	LTR	DESCRIPTION	DATE	DWN	APVD
	A3	Released as per ECR-07-012890	16-07-07	SK	TS
	A4	REVISED PER ECO-09-027197	13JAN10	KK	HMR


PN 2-6

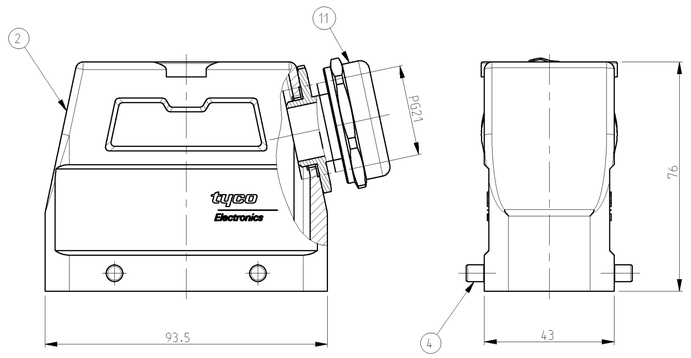


PN 1-6

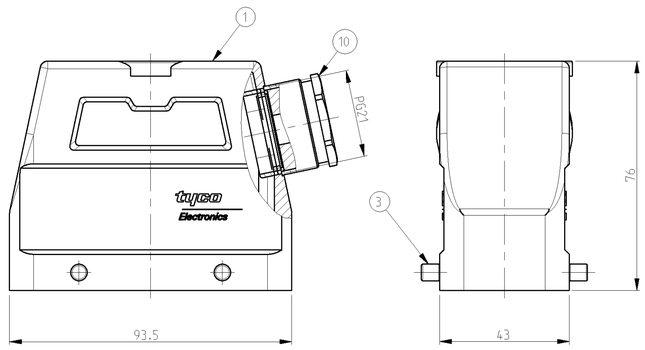


~~PN 1-7~~

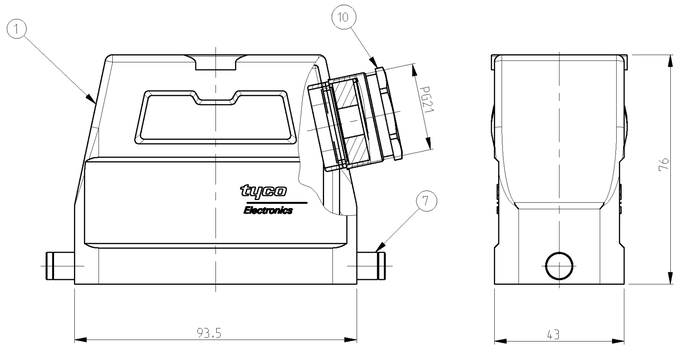

~~PN 1-1~~

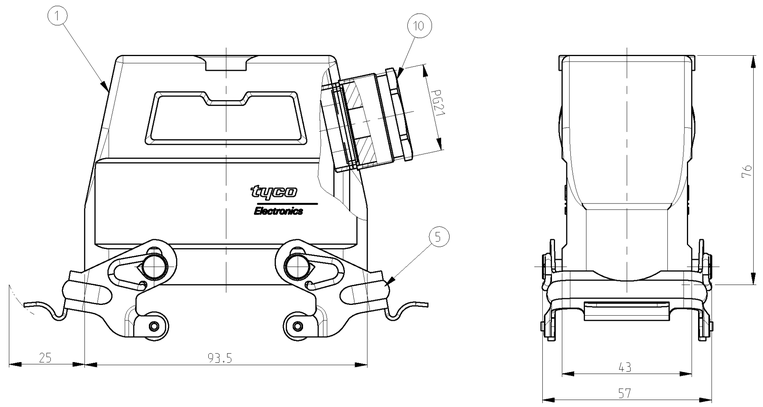

~~PN 2-7~~

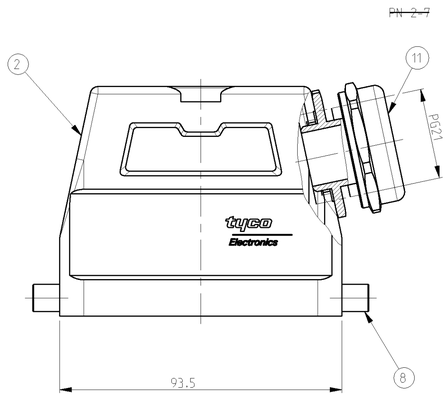

NOTES

1 Material: Housing: aluminium diecasting alloy
Seals:Neoprene


2 Surface:- powder-grey
black

3 Packaging
quantity 5 pieces in a box


4 Varnish on the inside not necessary

5 OBSOLETE PARTS: OBSOLETE CIS STREAMLINING PER D.RENAUD/D.SINISI

~~PN 2-7~~

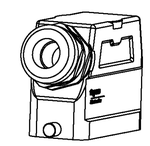

SCALE 1:2

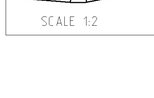~~PN 1-7~~	~~PN 1-1~~	PN 2-6	PN 1-6
			
SCALE 1:2	SCALE 1:2	SCALE 1:2	SCALE 1:2

OBSOLETE	OBSOLETE	OBSOLETE	OBSOLETE	OBSOLETE							
	1			1		HUT-Gland fitting PG21	Brass	Nickel plated	–	11	–
1		1			1	PG-Gland fitting PG21	Brass	Nickel plated	–	10	–
1						Cable fitting round	Steel	Zinc plated	Blue	9	–
	2					LB-Clip bolt	Stainless Steel	–	–	8	–
		2				LB-Clip bolt	Steel	Zinc plated	Blue	7	–
			2			VS-Side clip	Stainless Steel	–	–	6	–
				2		VS-Side clip	Steel	Zinc plated	Blue	5	–
					4	VS-Clip bolt	Stainless Steel	–	–	4	–
					4	VS-Clip bolt	Steel	Zinc plated	Blue	3	–
	1			1		HOOD HD.40.Pg.1.21	Alumimnium	Aluminium oxide	Black	2	–
1		1			1	HOOD HD.40.Pg.1.21	Alumimnium	–	Grey	1	–
1-3	2-7	1-7	2-1	1-1	2-6	1-6	DESCRIPTION	MATERIAL	SURFACE	COLOR	ITEM NO	NOTES

ORDERING TEXT

HD.40.Sts.1.21

HD-K.40.Sts.1.21

HD.40.Sts-VS.1.21

HD-K.40.Sts-VS.1.21

HD.40.Sts-GR.1.21

HD-K.40.Sts-GR.1.21

HD-Z.40.Sts-ZB.1.21

THIS DRAWING IS A CONTROLLED DOCUMENT OF TYCO ELECTRONICS CORPORATION IT IS SUBJECT TO CHANGE AND THE CONTROLLING ENGINEERING ORGANIZATION SHOULD BE CONTACTED FOR THE LATEST REVISION.

DWN Schneider 30.03.1999
CHK Schweiger 30.03.1997
APVD –

DIMENSIONS: mm

TOLERANCES UNLESS OTHERWISE SPECIFIED:
ANGLES ± 0°30'
0 PLC ± 0.25
1 PLC ± 0.1
2 PLC ± 0.05
3 PLC ± 0.025
4 PLC ± 0.01
ANGLES ± 1°

MATERIAL

FINISH

PRODUCT SPEC –

APPLICATION SPEC –

WEIGHT –

Tyco Electronics

Tyco Electronics, AMP GmbH
D-53819, Neunkirchen, Germany

NAME
HOOD
HD.40.STS.1.21

SIZE	CAGE CODE	DRAWING NO	RESTRICTED TO
A1	00779	C-1102562	–

CUSTOMER DRAWING

SCALE 1:1 SHEET 1 OF 1 REV A4