

THIS DRAWING IS UNPUBLISHED. RELEASED FOR PUBLICATION -,- .
© COPYRIGHT - By - ALL RIGHTS RESERVED.


LOC	DIST
H	—

REVISIONS

P	LTR	DESCRIPTION	DATE	DWN	APVD
	F1	2-163680-2 MARKED OBSOLETE	04OCT2021	SCB	SS

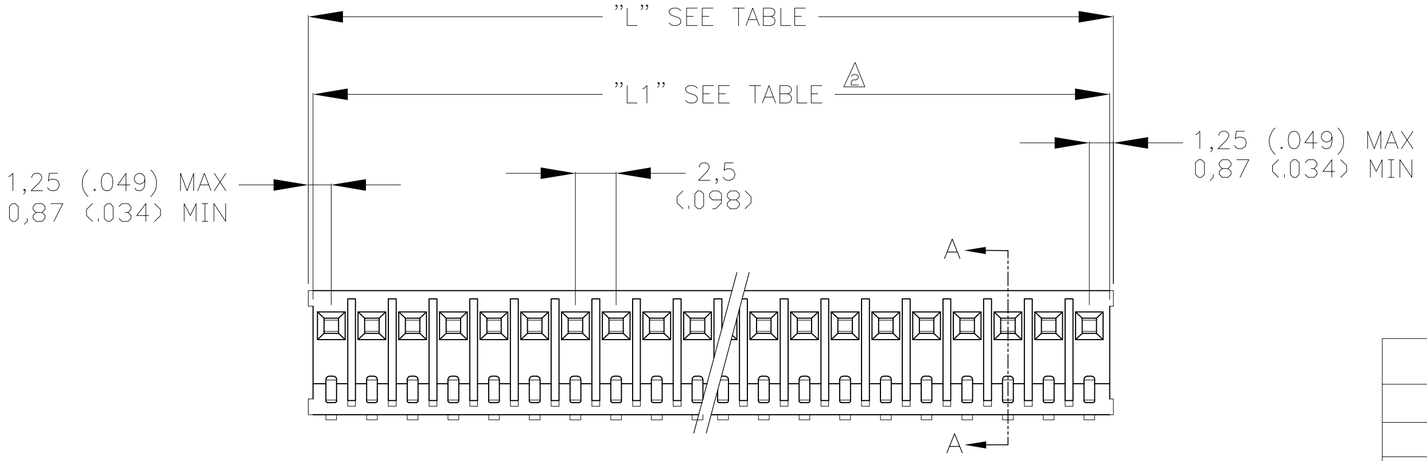

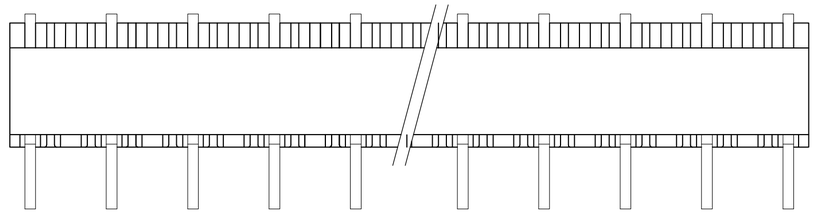

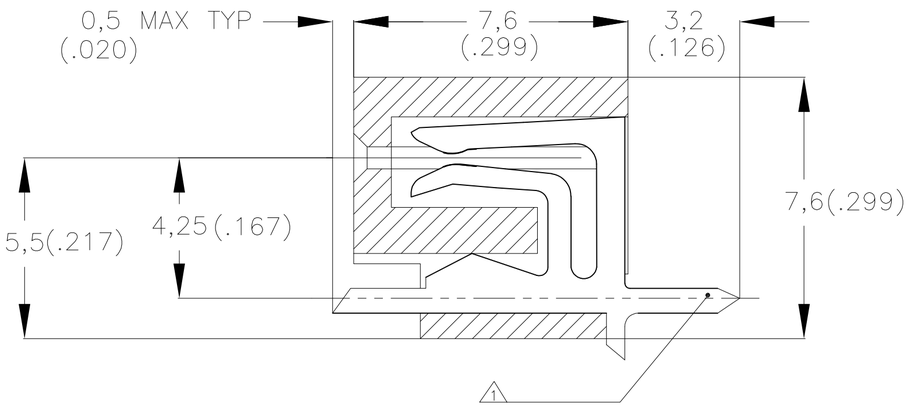

SECTION A-A

NOTES:

+0,1 +.004 +0,1 +.004 +0,1 +.004
−0,0 −.000 −0,0 −.000 −0,0 −.000

1. PREFERRED HOLE SIZE: 0,8 (.031) 0,9 (.035) 1,0 (.039) DEPENDING ON NUMBER OF POSITIONS OF CONNECTOR FOR MORE INFORMATION PLEASE CONTACT PRODUT−ENGINEERING DEPARTMENT.
2. ONLY FOR USE WITH G.M.T.S HEADERS
3. OBSOLETE

"L1" MAX. 2		"L" MAX		NUMBER OF LOADED POS.	ORDER NO.	
mm	(inches)	mm	(inches)			
7,3	0,287	7,6	0,300	3	163680−1	
9,8	0,386	10,1	0,398	4	163680−2	
12,3	0,484	12,6	0,497	5	163680−3	
14,8	0,582	15,1	0,595	6	163680−4	
17,3	0,681	17,6	0,694	7	163680−5	
19,8	0,779	20,1	0,792	8	163680−6	
22,3	0,878	22,6	0,890	9	163680−7	
24,3	0,976	25,1	0,989	1	~~163680−8~~	3
27,8	1,075	27,6	1,087	11	163680−9	
29,8	1,173	30,1	1,186	12	1−163680−1	
32,3	1,271	32,6	1,284	13	~~1−163680−2~~	3
34,8	1,370	35,1	1,382	14	~~1−163680−3~~	3
37,3	1,468	37,6	1,481	15	~~1−163680−4~~	3
39,8	1,567	40,1	1,579	16	~~1−163680−5~~	3
42,3	1,665	42,6	1,678	17	~~1−163680−6~~	3
44,8	1,764	45,1	1,776	18	~~1−163680−7~~	3
47,3	1,862	47,6	1,875	19	~~1−163680−8~~	3
49,8	1,960	50,1	1,973	20	1−163680−9	
		52,6	2,071	21	~~2−163680−0~~	3
		55,1	2,170	22	2−163680−1	
		57,6	2,268	23	~~2−163680−2~~	3
		60,1	2,367	24	~~2−163680−3~~	3

MATERIAL

HOUSING: GRAY CRASTIN SK643FR

RECEPTACLES: BRASS: TIN PLATED OVER NICKEL-BARRIER

THIS DRAWING IS A CONTROLLED DOCUMENT.

DIMENSIONS: mm [INCHES]

TOLERANCES UNLESS OTHERWISE SPECIFIED:
0 PLC ± −
1 PLC ± −
2 PLC ± −
3 PLC ± −
4 PLC ± −
ANGLES ± −

MATERIAL: SEE TABLE

FINISH: −

DWN 16−03−1973 —
CHK 19−03−1973 —
APVD — —
PRODUCT SPEC —
APPLICATION SPEC —
WEIGHT —

TE Connectivity

NAME: FEMALE CONN.FOR COMMERCIAL INTERCONNECTION SYSTEM 2,5mm PITCH. TOP ENTRY

SIZE	CAGE CODE	DRAWING NO	RESTRICTED TO
A2	00779	C−163680	—

CUSTOMER DRAWING | SCALE 4:1 | SHEET 1 OF 1 | REV F1

163680

1471−9 (3/11)